



COPY OF PAPERS
ORIGINALLY FILED

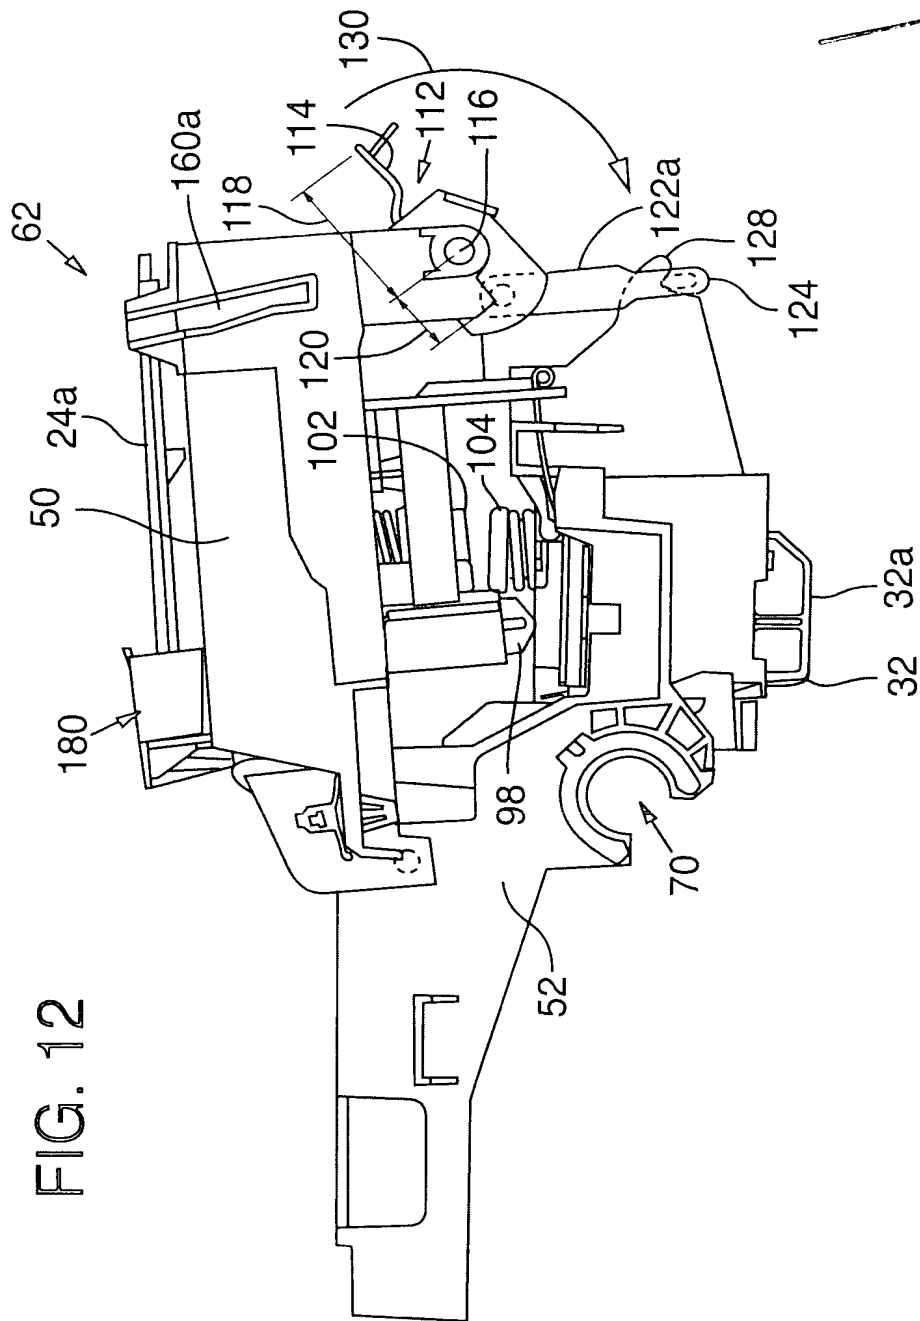


FIG. 12



COPY OF PAPERS
ORIGINALLY FILED


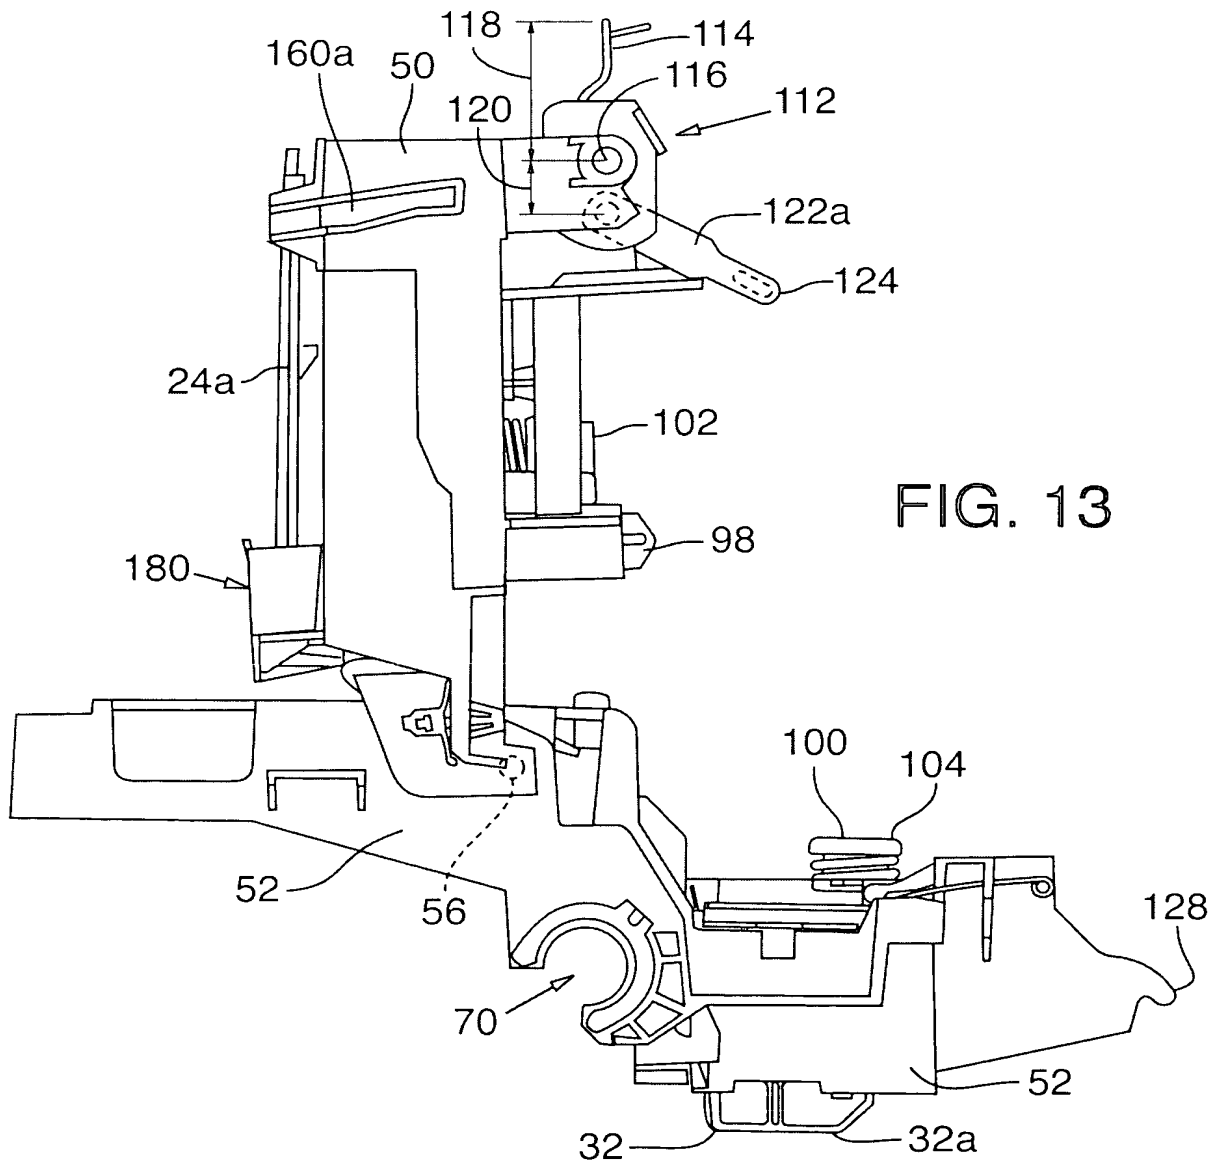


FIG. 13

Redlined Correction of Sheet No. 6.

COPY OF PAPERS
ORIGINALLY FILED



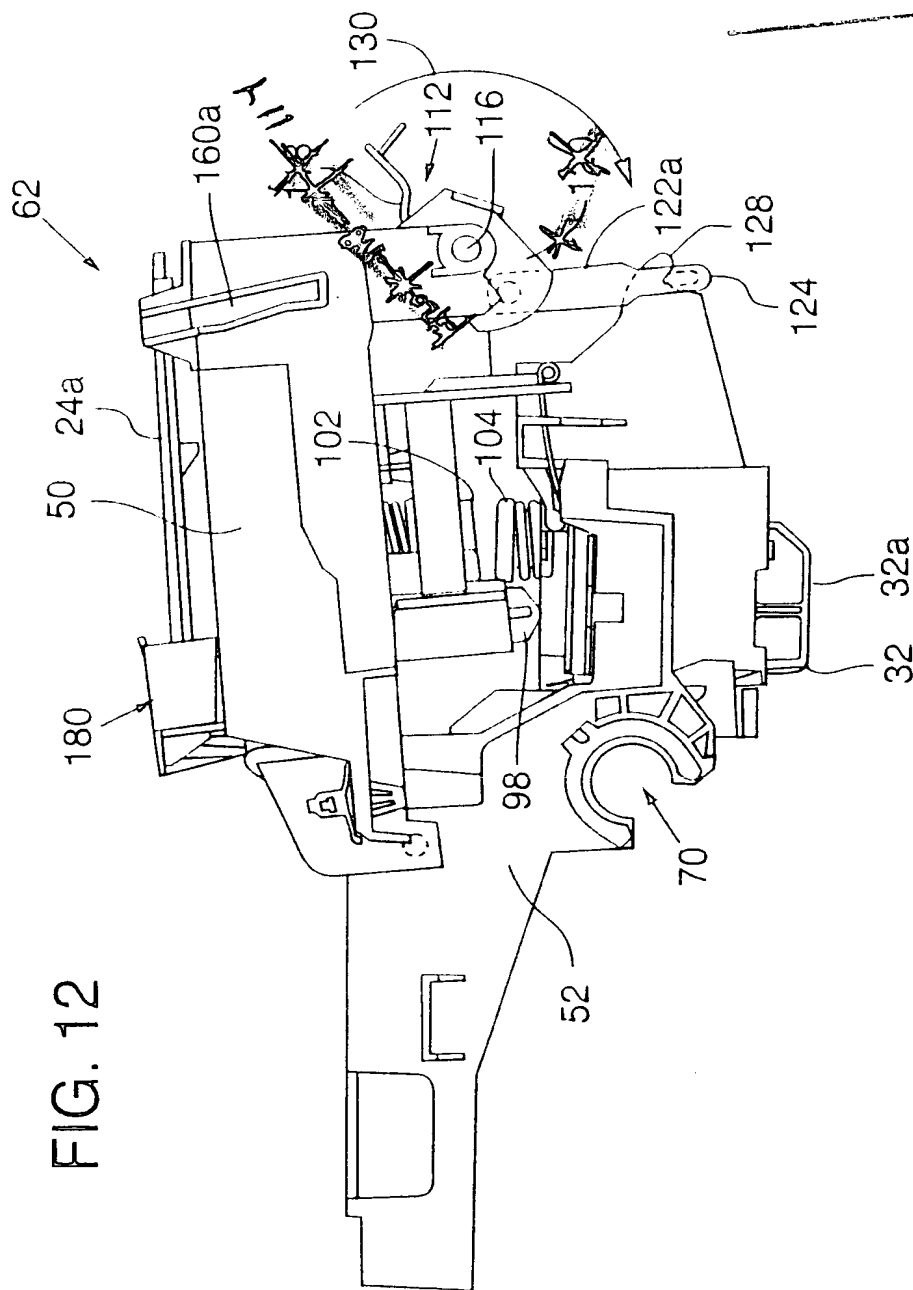

717

Redlined Correction of Sheet 7.

